


2013-2014 Barbour County Courthouse

AS-BUILT SIDEWALK AND PARKING RENOVATIONS

Philippi, West Virginia

Phil Hart County Commissioner
 Tim McDaniel County Commissioner
 Jedd Schola County Commissioner
 Chuck Foley 2013 County Administrator
 Jeff Rogers 2014 County Administrator

Project Location

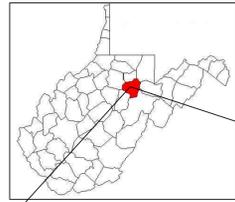

SHEET INDEX

Sheet 1	COVER SHEET
Sheet 2	FINAL CONDITIONS AND ELEVATIONS
Sheet 3	DURING AND AFTER CONSTRUCTION PHOTOS



Above Image from Google Earth on November 13, 2013



Final Plans certified by:

Michael Green

Michael Green, P. E. No. 7621

Date: August 4, 2014

BARBOUR COUNTY COMMISSION
 Philippi, West Virginia

Green Engineering Inc.

9154 Morgantown Pike
 Philippi, West Virginia 26416
 Telephone No. 304-457-3441

COVER SHEET

REVISION DATES	FIELD SURVEY BY MG and GS	DRAWN BY AC	SCALE OF MAP As Noted
	PLOTTED BY HP	CHECKED BY MG	PROJECT NUMBER 2012-BR08
	DATE OF MAP July 24, 2014	FINAL APPROVAL BY BCC	SHEET 1 OF 3