



Scale: 1 inch = 10 feet Horizontal and Vertical

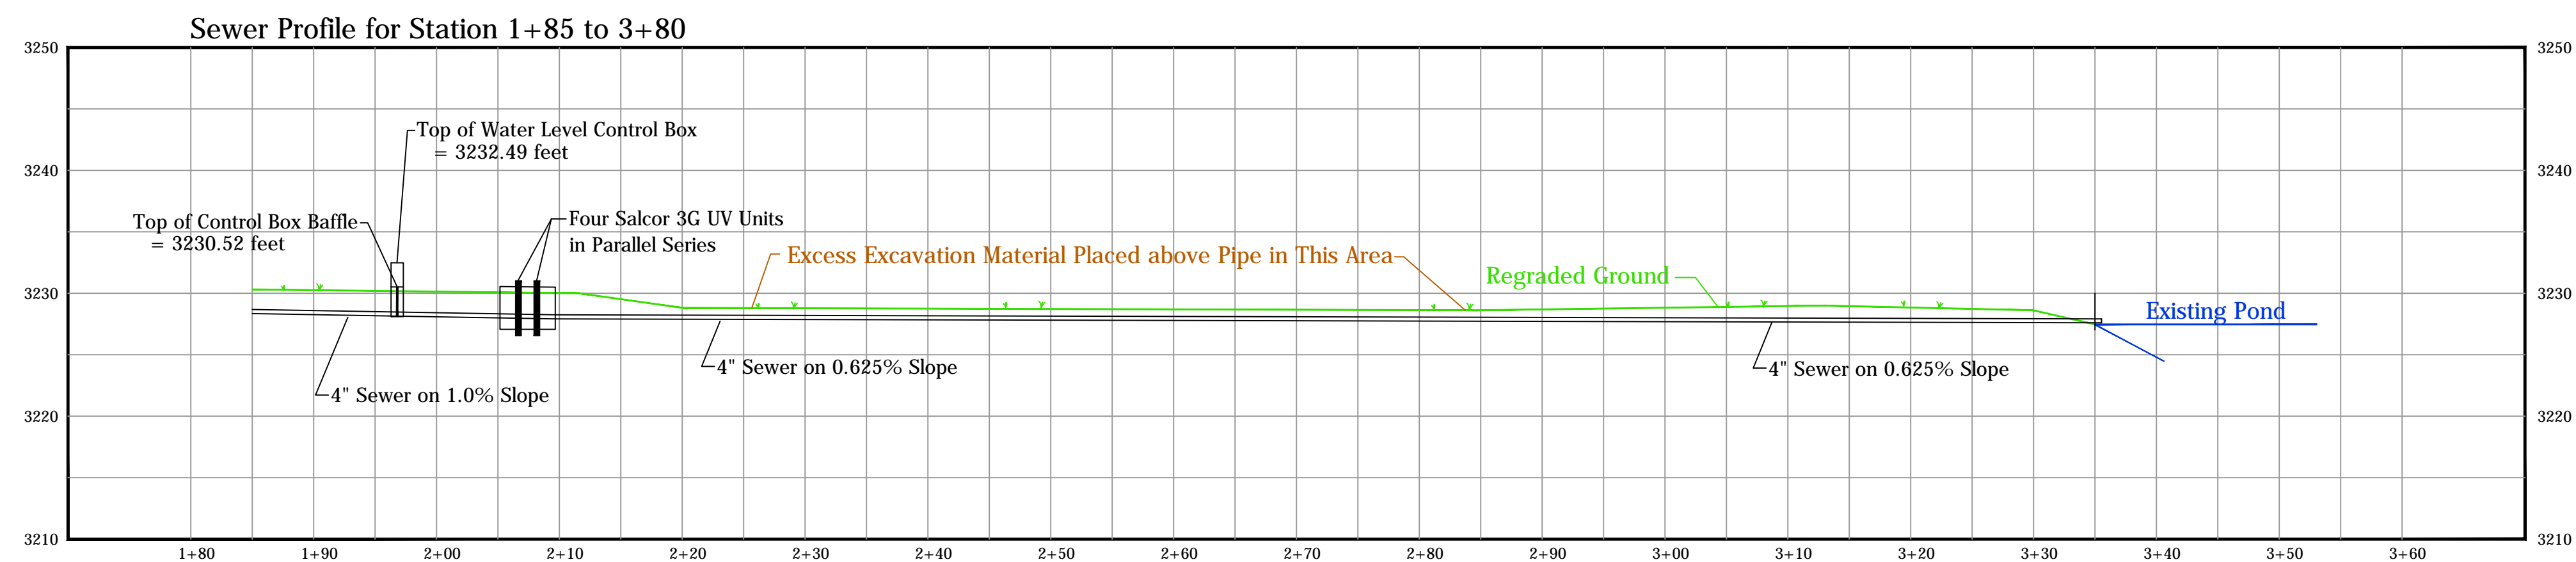

Wetland Notes

1. Total Rock Thickness of Wetland is 24 inches.
2. Mulch Layer is 2 to 4 inches thick.
3. Wetland was built into existing ground approximately 12 inches deep.
4. 1,100 Soft, Common Rush and Green Bulrush planted in 24' x 48' area.

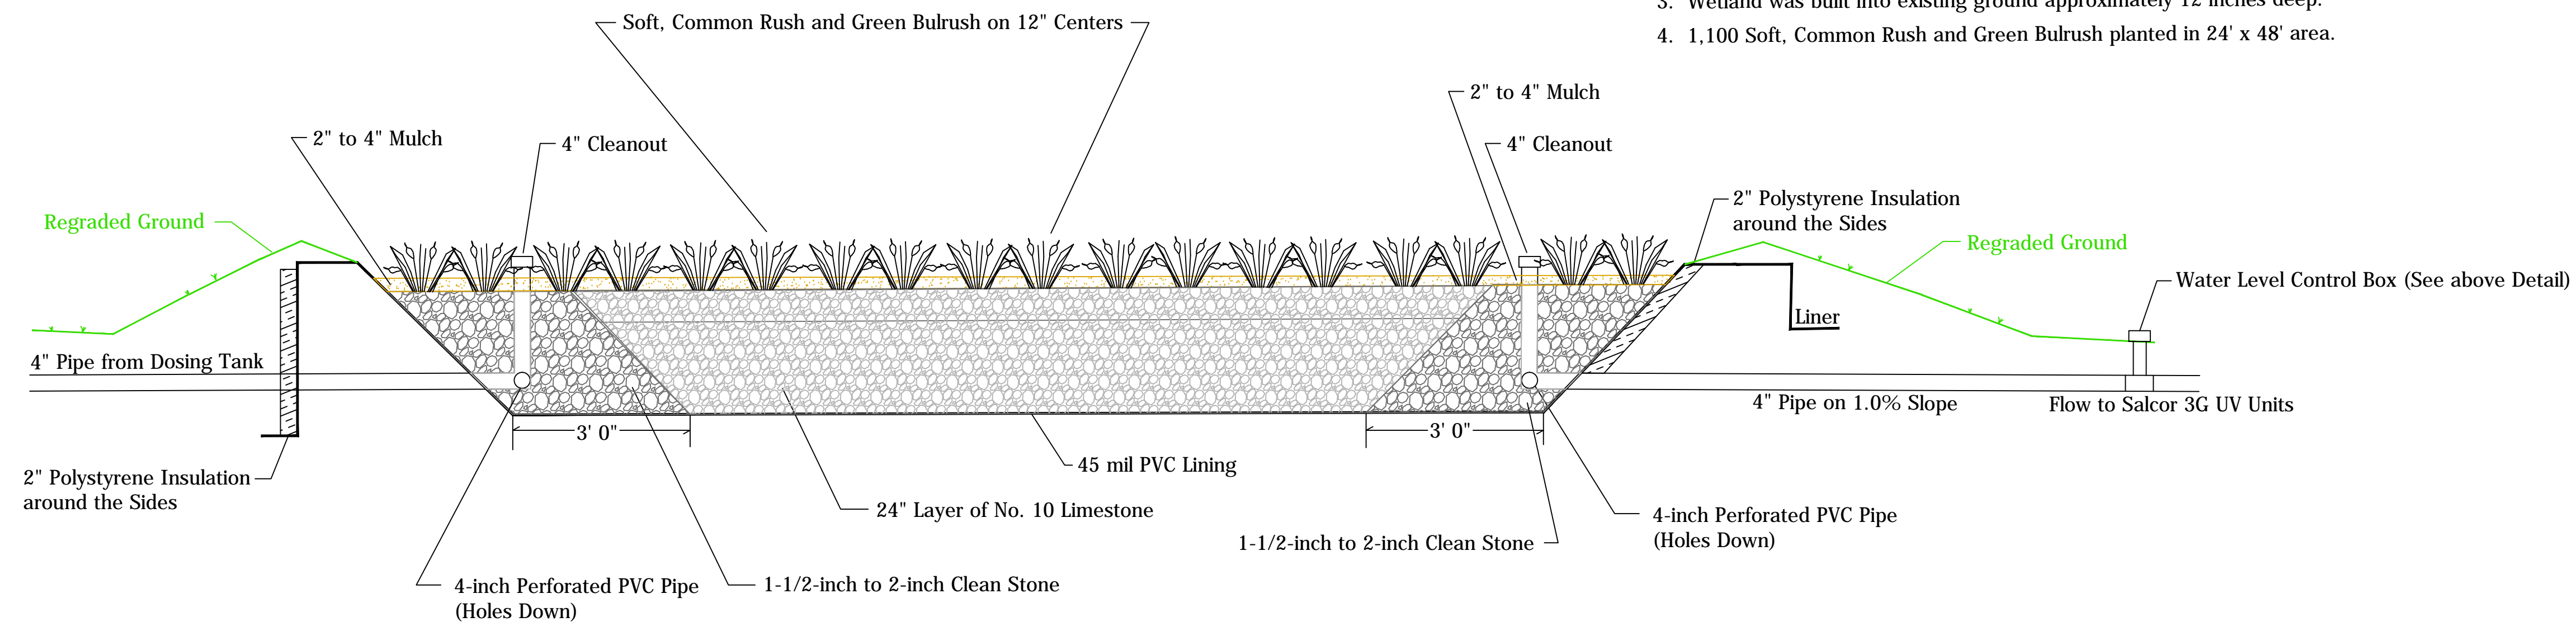

Wetland Cross-Section

No Scale

Canaan Valley FWS Septic System 6263 Appalachian Highway Davis, WV 26260			
		Sewer Profiles and Wetland Cross-Section	
<small>9154 Morgantown Pike Phillippi, West Virginia 26416 Telephone: 304-457-3441</small>			
<small>REVISION DATES</small>			
<small>April 10, 2016</small>			
<small>June 29, 2016</small>	<small>FIELD SURVEY BY MG and GS</small>	<small>DRAWN BY AC</small>	<small>SCALE OF MAP As Noted</small>
<small>Sept. 21, 2016</small>	<small>PLOTTED BY HP</small>	<small>CHECKED BY MG</small>	<small>PROJECT NUMBER 2015-TC02</small>
<small>DATE OF MAP August 20, 2015</small>	<small>FINAL APPROVAL BY US Fish & Wildlife</small>	<small>SHEET</small>	<small>2 OF 5</small>